


**GENERAL PERMIT**

Board of County Commissioners  
Lucas County, Ohio

*Office of the County Engineer*

1049 S. McCord Road  
Holland, Ohio 43528

Phone: 419-213-2860  
Fax: 419-213-2829

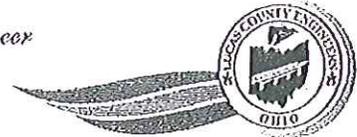

*Keith J. Early, P.E., P.S.*  
Lucas County Engineer

County Permit Application No. 17-008

Liability Insurance Amount \_\_\_\_\_

This permit is granted to Buckeye Cablevision, Inc.

2700 Oregon Rd. Northwood, OH 43619

Email Address: epinaya@telesystem.us

Telephone No. (419 ) 724-3786

hereinafter called the permit holder. The permit is granted subject to all terms, conditions, restrictions printed below and on the reverse side and to any plans, sketches or special instructions attached.

**LOCATION OF WORK:**

Scott Rd. at Airport Hwy.

**DESCRIPTION OF WORK:**

Install about 245 ft of fiber optic cable on existing utility poles along the west side right-of-way of Scott Rd. and crossing over Scott Rd. 253 ft to an existing utility pole on the east side R/W

Work Involves: Dewatering  Shoring  Open Cut  Tunneling  Boring/Jacking   
(In Pavement)

Other (Describe)  Aerial utility construction in the R/W

Damage may occur to berm  guardrail  traffic signs  shoulder  curb  structures   
storm drainage  sidewalks  pavement  underdrains

Other (Describe)  \_\_\_\_\_

\_\_\_\_\_no damage anticipated

The permit holder hereby agrees to indemnify and save harmless the County of Lucas and the members of the Board, and the Board of Township Trustees of the Township in which the work is to be performed, individually and as a Board against any and all liability, loss, damages, cost of expense which they or it may hereafter incur, suffer or be required to pay by reason of the work done under this permit.

The permit holder shall notify the County Engineer, two (2) working days in advance of commencing the work under this permit, unless a detour is necessary, where seven (7) calendar days is required. Contact the Lucas county Engineer's Construction Department @ (419) 213-2860.



SITE PLAN # 16-0256

SUBDIV. \_\_\_\_\_

This permit shall be in the possession of the permit holder's employee in charge of the work and shall be shown on request to any employee of the County Engineer.

The permit holder hereby agrees to backfill all trenches under pavement and paved berms and within 5 feet from edge of pavement and paved berms in accordance with 603.08 and 603.09 using granular material meeting the current O.D.O.T. specifications for 703.11, using compaction equipment and having an inspector present.

The permit holder also agrees to place a temporary wearing surface consisting of a 3" thickness of Asphalt Cold Mix immediately upon backfilling of the trench; and to maintain the road surface which has been disturbed until such a time as the permanent pavement can be replaced to the satisfaction of the County Engineer. Permanent pavement replacement shall match the existing asphalt/stone composition or the Lucas County minimum pavement replacement standards (4" asphaltic concrete on 10" aggregate base), whichever is greater.

The permit holder also hereby agrees to furnish and maintain lights, signs, barricades and flaggers necessary for the protection of traffic at all times, day and night, during the work provided for under this permit, and to comply with all instructions given by the County Engineer as to handling of traffic. All traffic control devices, flaggers, traffic maintenance methods and other operations to provide for protection of traffic shall conform to the requirements of the Ohio Department of Transportation Construction and Materials Specifications, Current Edition and the Ohio Department of Transportation, Manual of Uniform Traffic Control Devices for Streets and Highways, current edition, including all applicable revisions. Describe briefly and include a sketch of the traffic control and maintenance anticipated for this project.

---

---

---

The permit holder also hereby agrees to keep all pavement, drive areas, etc. clean within work and haul areas and to restore all disturbed areas to the condition that existed prior to the work to the satisfaction of the County Engineer.

The permit holder agrees to comply with all the conditions, restrictions and regulations of the County Engineer.

If the party or parties to whom this permit is issued does anything contrary to the orders of the County Engineer and after due notice fails to correct such work, remove such structure or material as he may be ordered to remove, or place protective material, device or flaggers, the County Engineer, may with or without further or additional notice, correct such work, remove such structure or material, or place protective material, device or flaggers. The party or parties to whom this permit is issued shall reimburse the County Engineer for any expense incurred in correcting the work, removing the structure or materials or making the construction area safe for the traveling public.

No revisions to the work described in this permit will be allowed without the prior approval of the County Engineer.

This permit may at any time be revoked or annulled for non-performance of or noncompliance with any of the said conditions, restrictions and regulations thereof.

The permit holder agrees to perform said work described in accordance with the Ohio Department of Transportation's current editions of Construction and Material Specifications, this permit and all special conditions and attachments.

The permit holder agrees for a one-year period after the completion of this work, to guarantee the replacement or restoration of all items damaged directly or indirectly as a result of the work.

All work is subject to the approval and inspection of the County Engineer. Please contact the Lucas County Engineer's Construction Department @ (419) 213-2860 for a final inspection prior to any backfilling.

All work done under this permit within the right of way limits shall be subject to removal or relocation by the permit holder at his expense at the direction of the County Engineer in the event any public improvement shall require that said work be done.

Said work is to be done in a timely fashion and any additional cost due to the delay of removal or relocation by permit holder will be assessed to the permit holder.

A schedule of work to be completed in the public right of way must be submitted 2 weeks prior to starting work. If schedule changes, contact Lucas County Engineer's Construction Department @ (419) 213-2860.

Failure to notify the above may result in permit being revoked.

In case of emergency, notify the following: (Evenings, Weekends, Holidays)

Name Enrique Pinaya, PE

Title Engineering Manager

Address 2700 Oregon Rd. Northwood, OH 43619

Email Address epinaya@telesystem.us

Telephone No. (419) 724-3786 Fax No. (419) 389-0052

Anticipated date to begin construction Mar. 1, 2017

Approximate length of time for construction 60 days

Additional limitations and special conditions shall be as follows:

*The last pole to the north on the west side is located w/in the Village of Swanton. You will need permission from them.*

Application made by: Enrique Pinaya, PE  
(Printed)

*Enrique Pinaya* 12/18/16  
(Signature) (Date)

Please select how you would like to receive your permit:

- U.S. Mail
- Email

Attach plans, sketches and Certificate of Insurance

DO NOT WRITE BELOW THIS LINE


Application Recommended by: *John R. Hyl* 1/3/17  
Date

Approved by: *Keith Earley* 1/5/17  
Date  
Keith G. Earley  
Lucas County Engineer

This permit issued by the Lucas County Engineer under authority granted by the Board of Lucas County Commissioners and/or the Board of Township Trustees.

Lucas County Engineer  
1049 S. McCord Road  
Holland, Ohio 43528  
Telephone No.: 419-213-2860  
Fax No.: 419-213-2829

County Rd. \_\_\_\_\_  
Township Rd. Scott  
Township Swanton

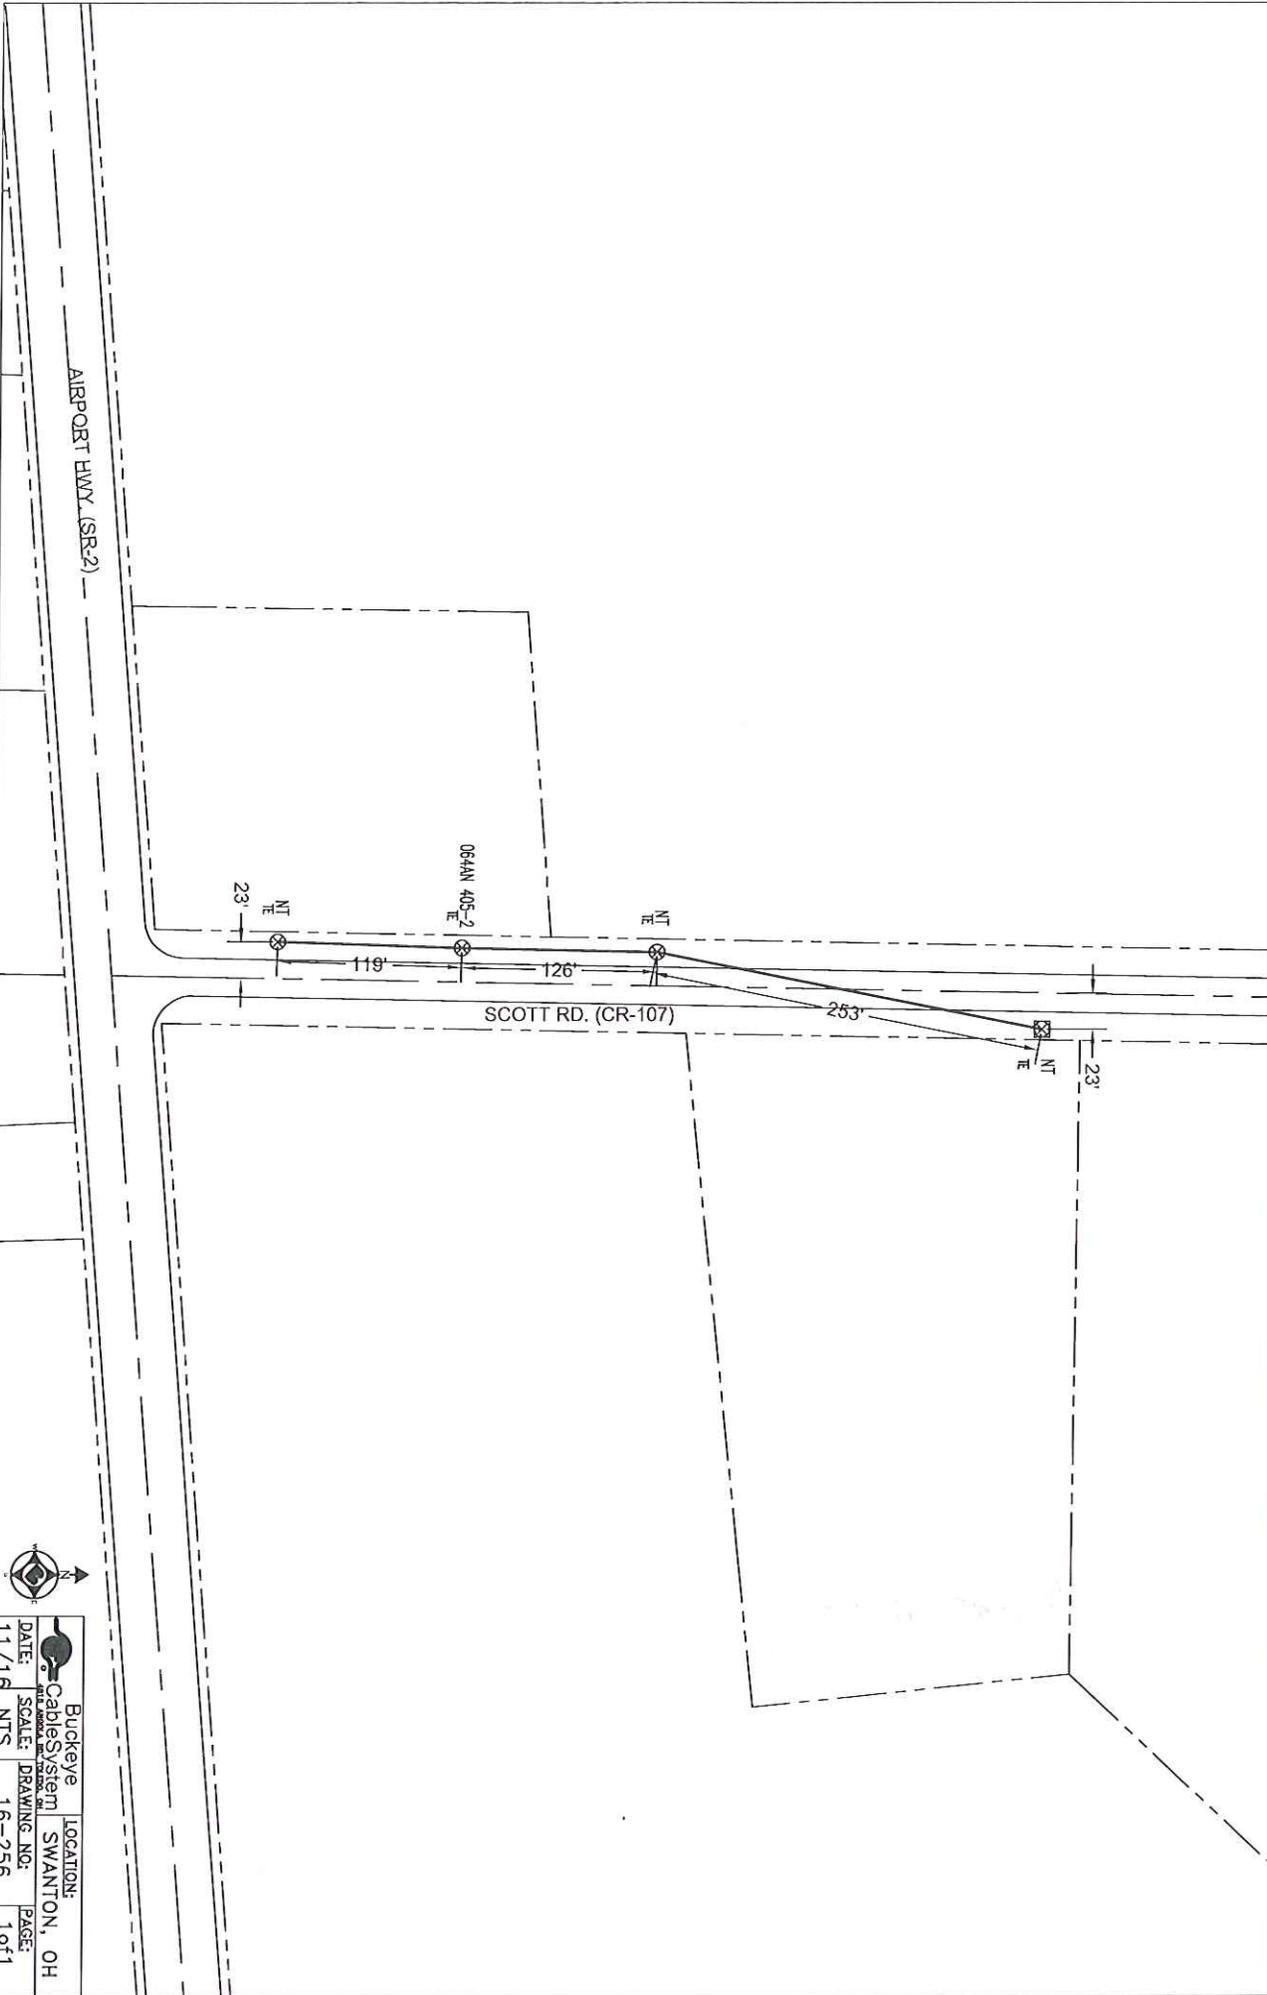

		Buckeye CableSystem <small>THE AMERICAN CABLE COMPANY</small>	Location: SWANTON, OH
DATE:	11/16	SCALE:	NTS
DRAWING NO.:	16-256	PAGE:	1 of 1